







Barrier-free path from barrier-free trailer parking to Barrier-free launching pier

Barrier-free launching pier

Launching pier

2 lane boat launch

2 barrier-free trailer parking spaces


28 Trailer Parking Spaces

1 barrier-free trailer parking space

Barrier-free path

~ 27 trailer parking spaces and 3 barrier-free trailer parking spaces; 2 lane boat launch; Barrier-free launching pier and regular launching pier; Barrier-free path from barrier-free trailer space to barrier-free launching pier; Barrier-free restroom; Barrier-free path from barrier-free trailer space to barrier-free restroom



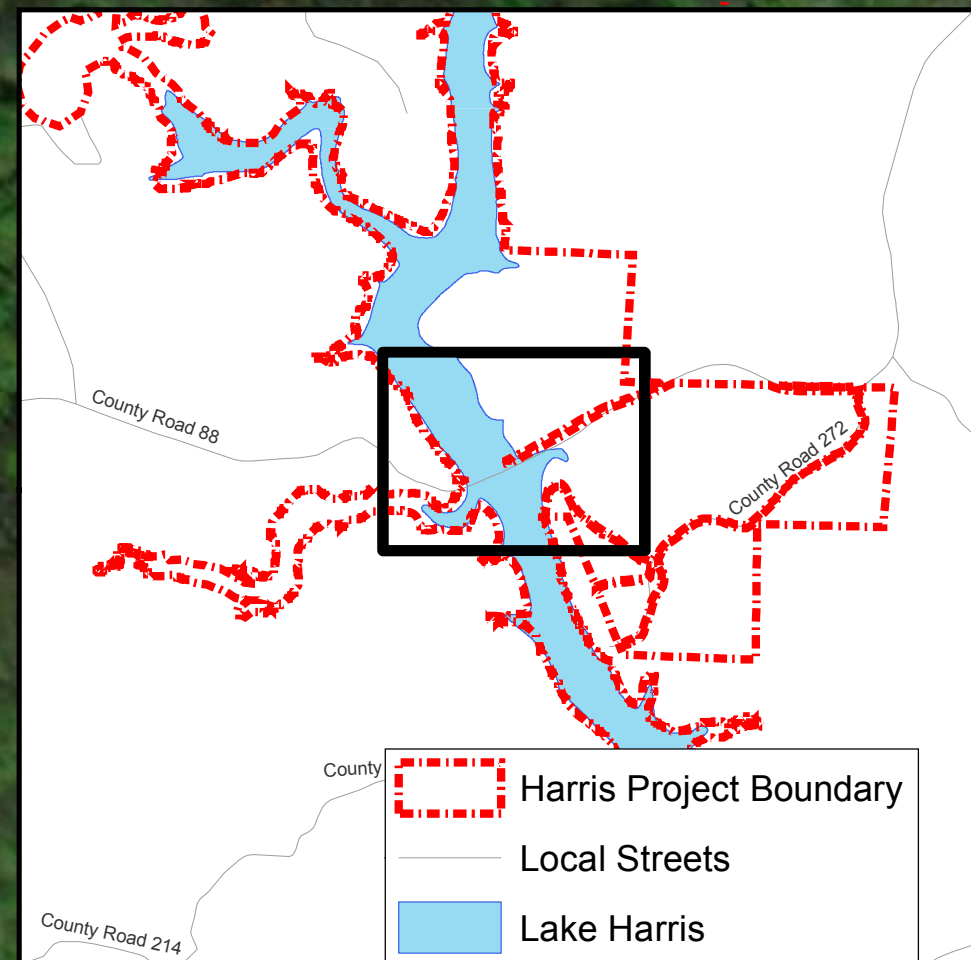



RANDOLPH CO. RD. 88


MAP EXTENT OF PAGE 2


Aerial Imagery of Lee's Bridge Boat Ramp Showing Harris Dam Project Boundary in Relation to Site Relicensing As-Built 2020 Updates P-2628  
Sheet 1 of 2

 Harris Project Boundary

 Alabama Power

Aerial Imagery captured in 2016



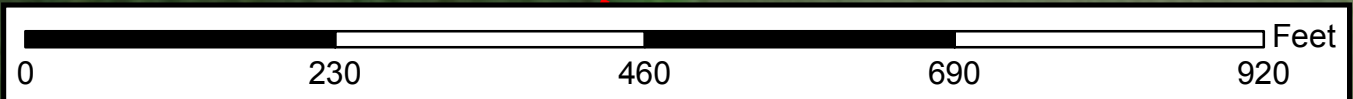



Aerial Imagery of Lee's Bridge  
Boat Ramp  
Relicensing As-Built 2020  
P-2628  
Updates Sheet 2 of 2

Alabama Power Aerial Imagery captured in 2020



PATH FROM PARKING LOT TO LAUNCHING PIER


LAUNCHING PIER

4 TRAILER PARKING SPACES

1 LANE BOAT LAUNCH

~4 trailer parking spaces; 1 lane boat launch; 1 launching pier; Path from parking lot to launching pier



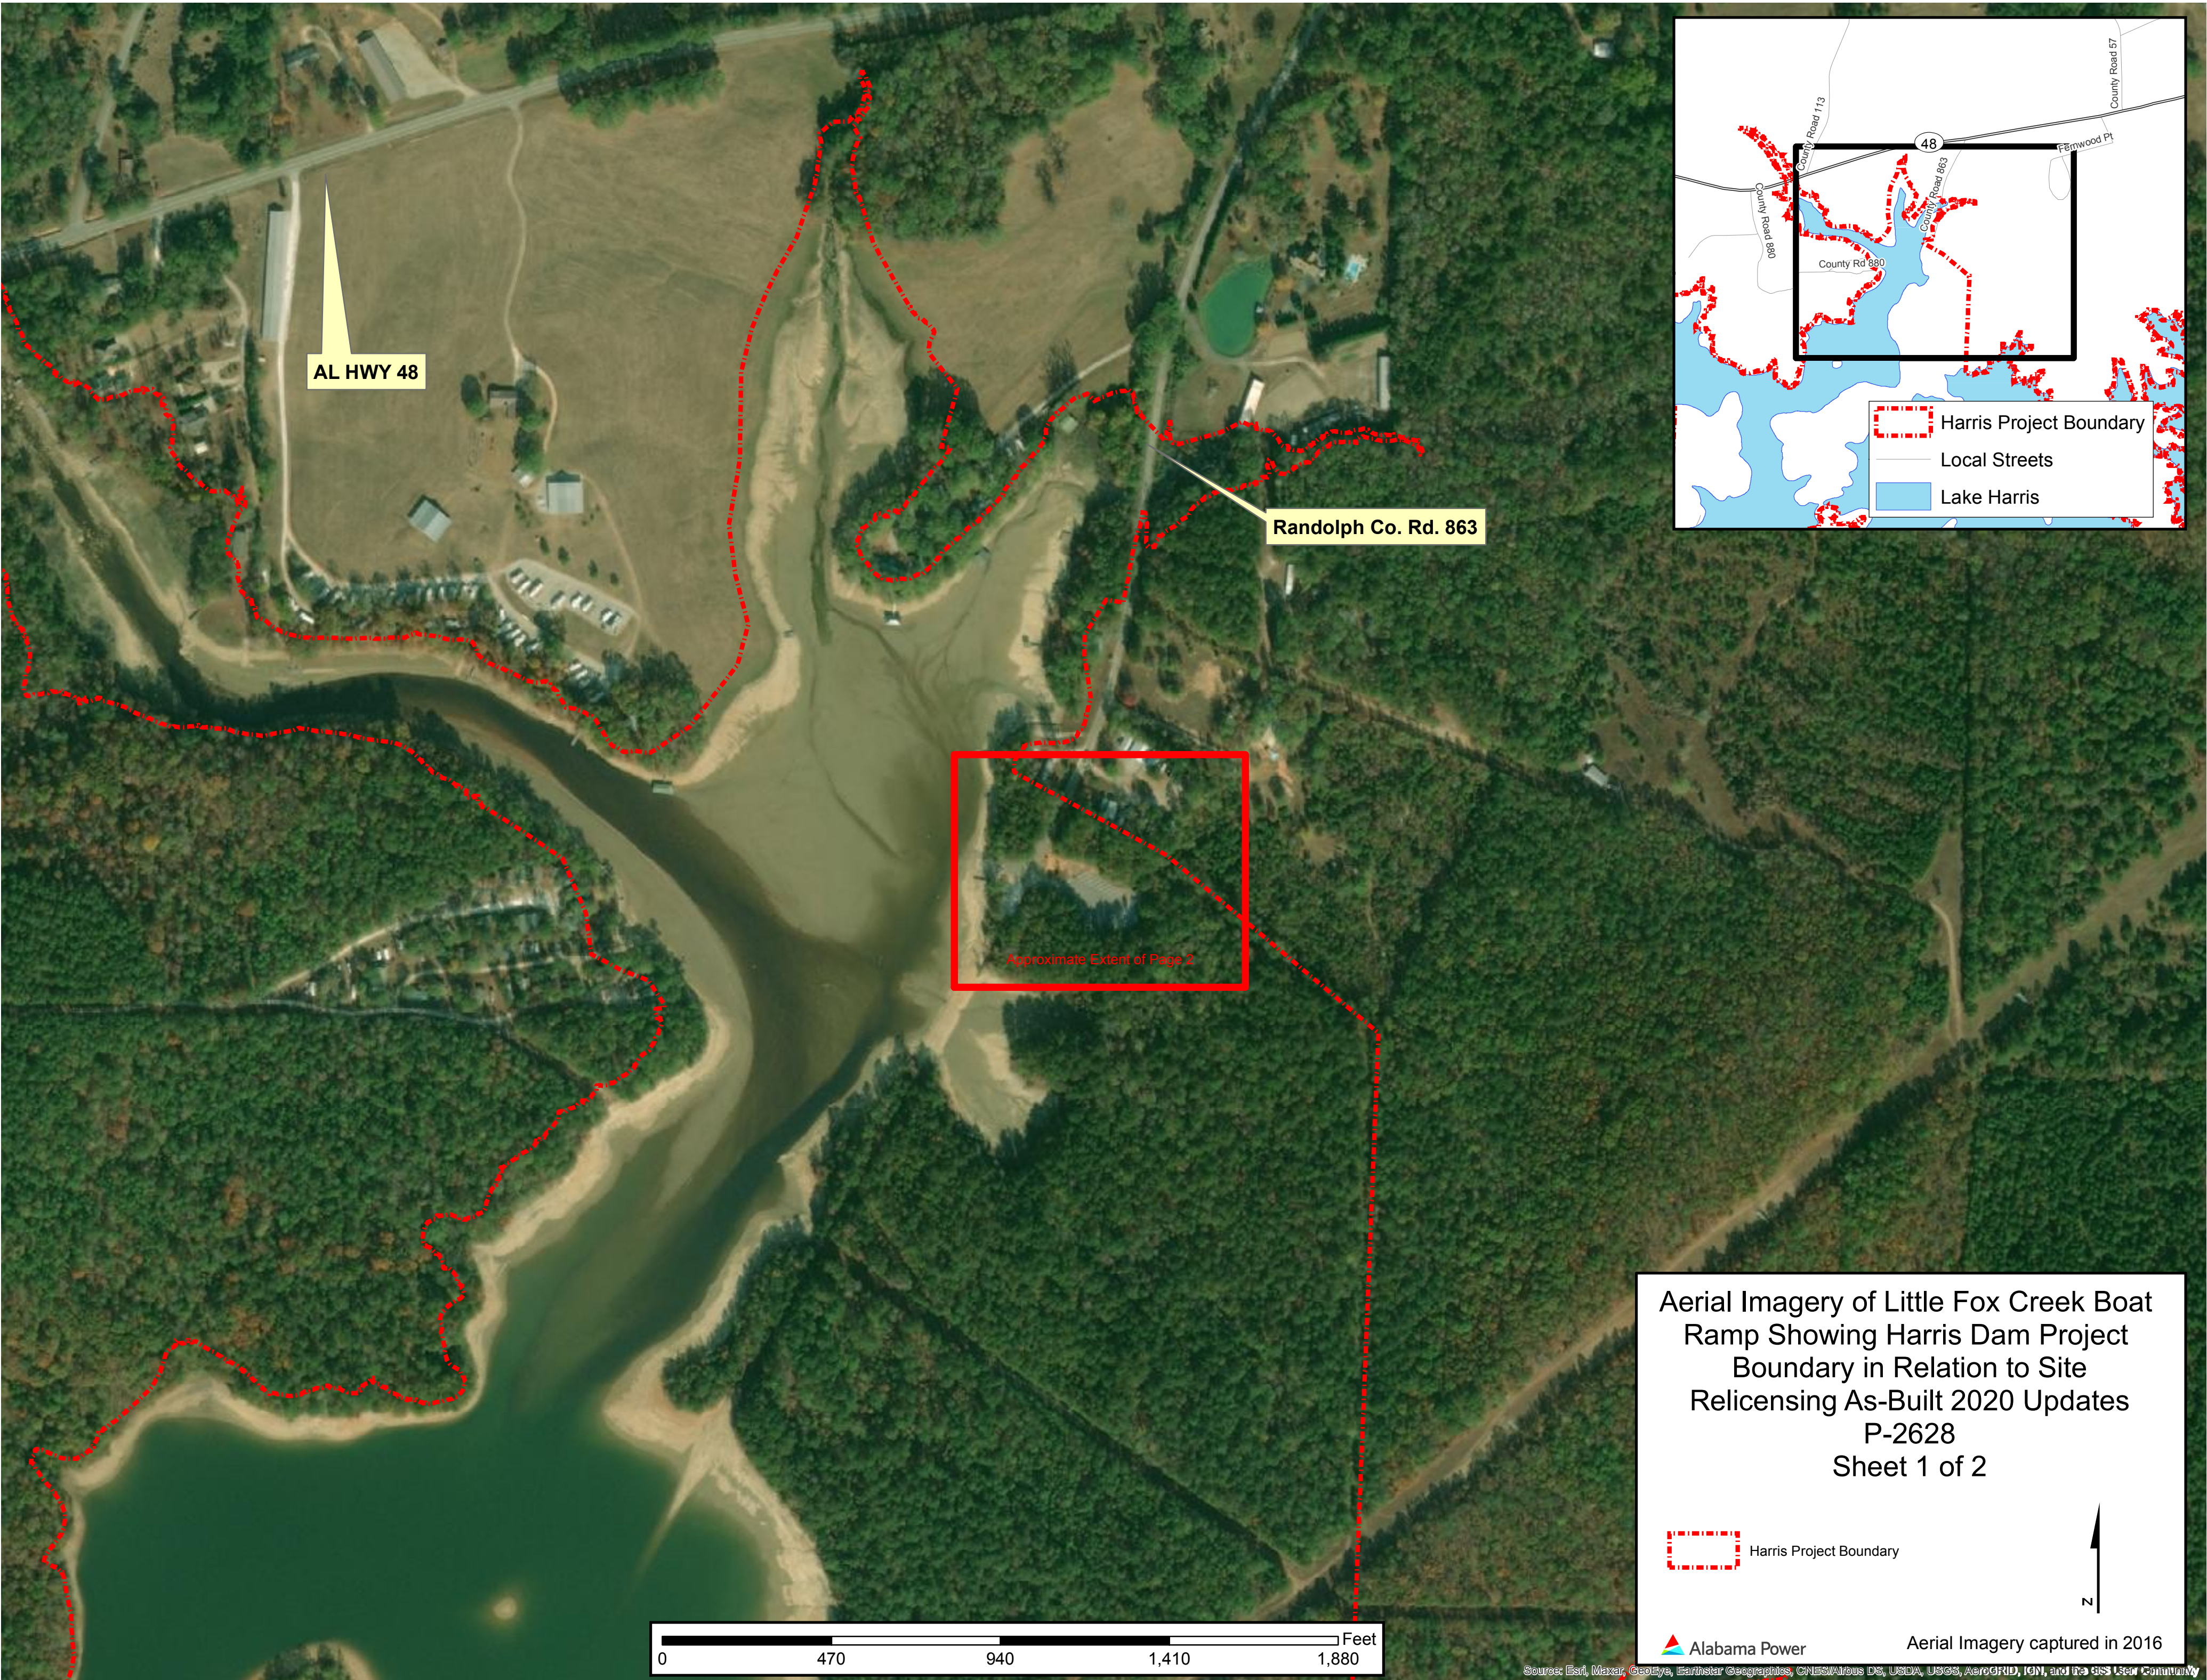



Aerial Imagery of Little Fox Creek  
Boat Ramp Relicensing As-Built  
2020 Updates  
P-2628  
Sheet 2 of 2

Alabama Power Aerial Imagery captured in 2017


BARRIER-FREE PATH FROM BARRIER-FREE TRAILER PARKING  
TO BARRIER-FREE LAUNCHING PIER AND 2 LANE BOAT LAUNCH

20 TRAILER PARKING SPACES

2 BARRIER-FREE TRAILER PARKING SPACES

~ 20 trailer parking spaces and 2 barrier-free trailer  
parking spaces; Barrier-free launching pier; Barrier-  
free path from barrier-free trailer parking space to  
barrier-free launching pier and boat launch;  
2 lane boat launch



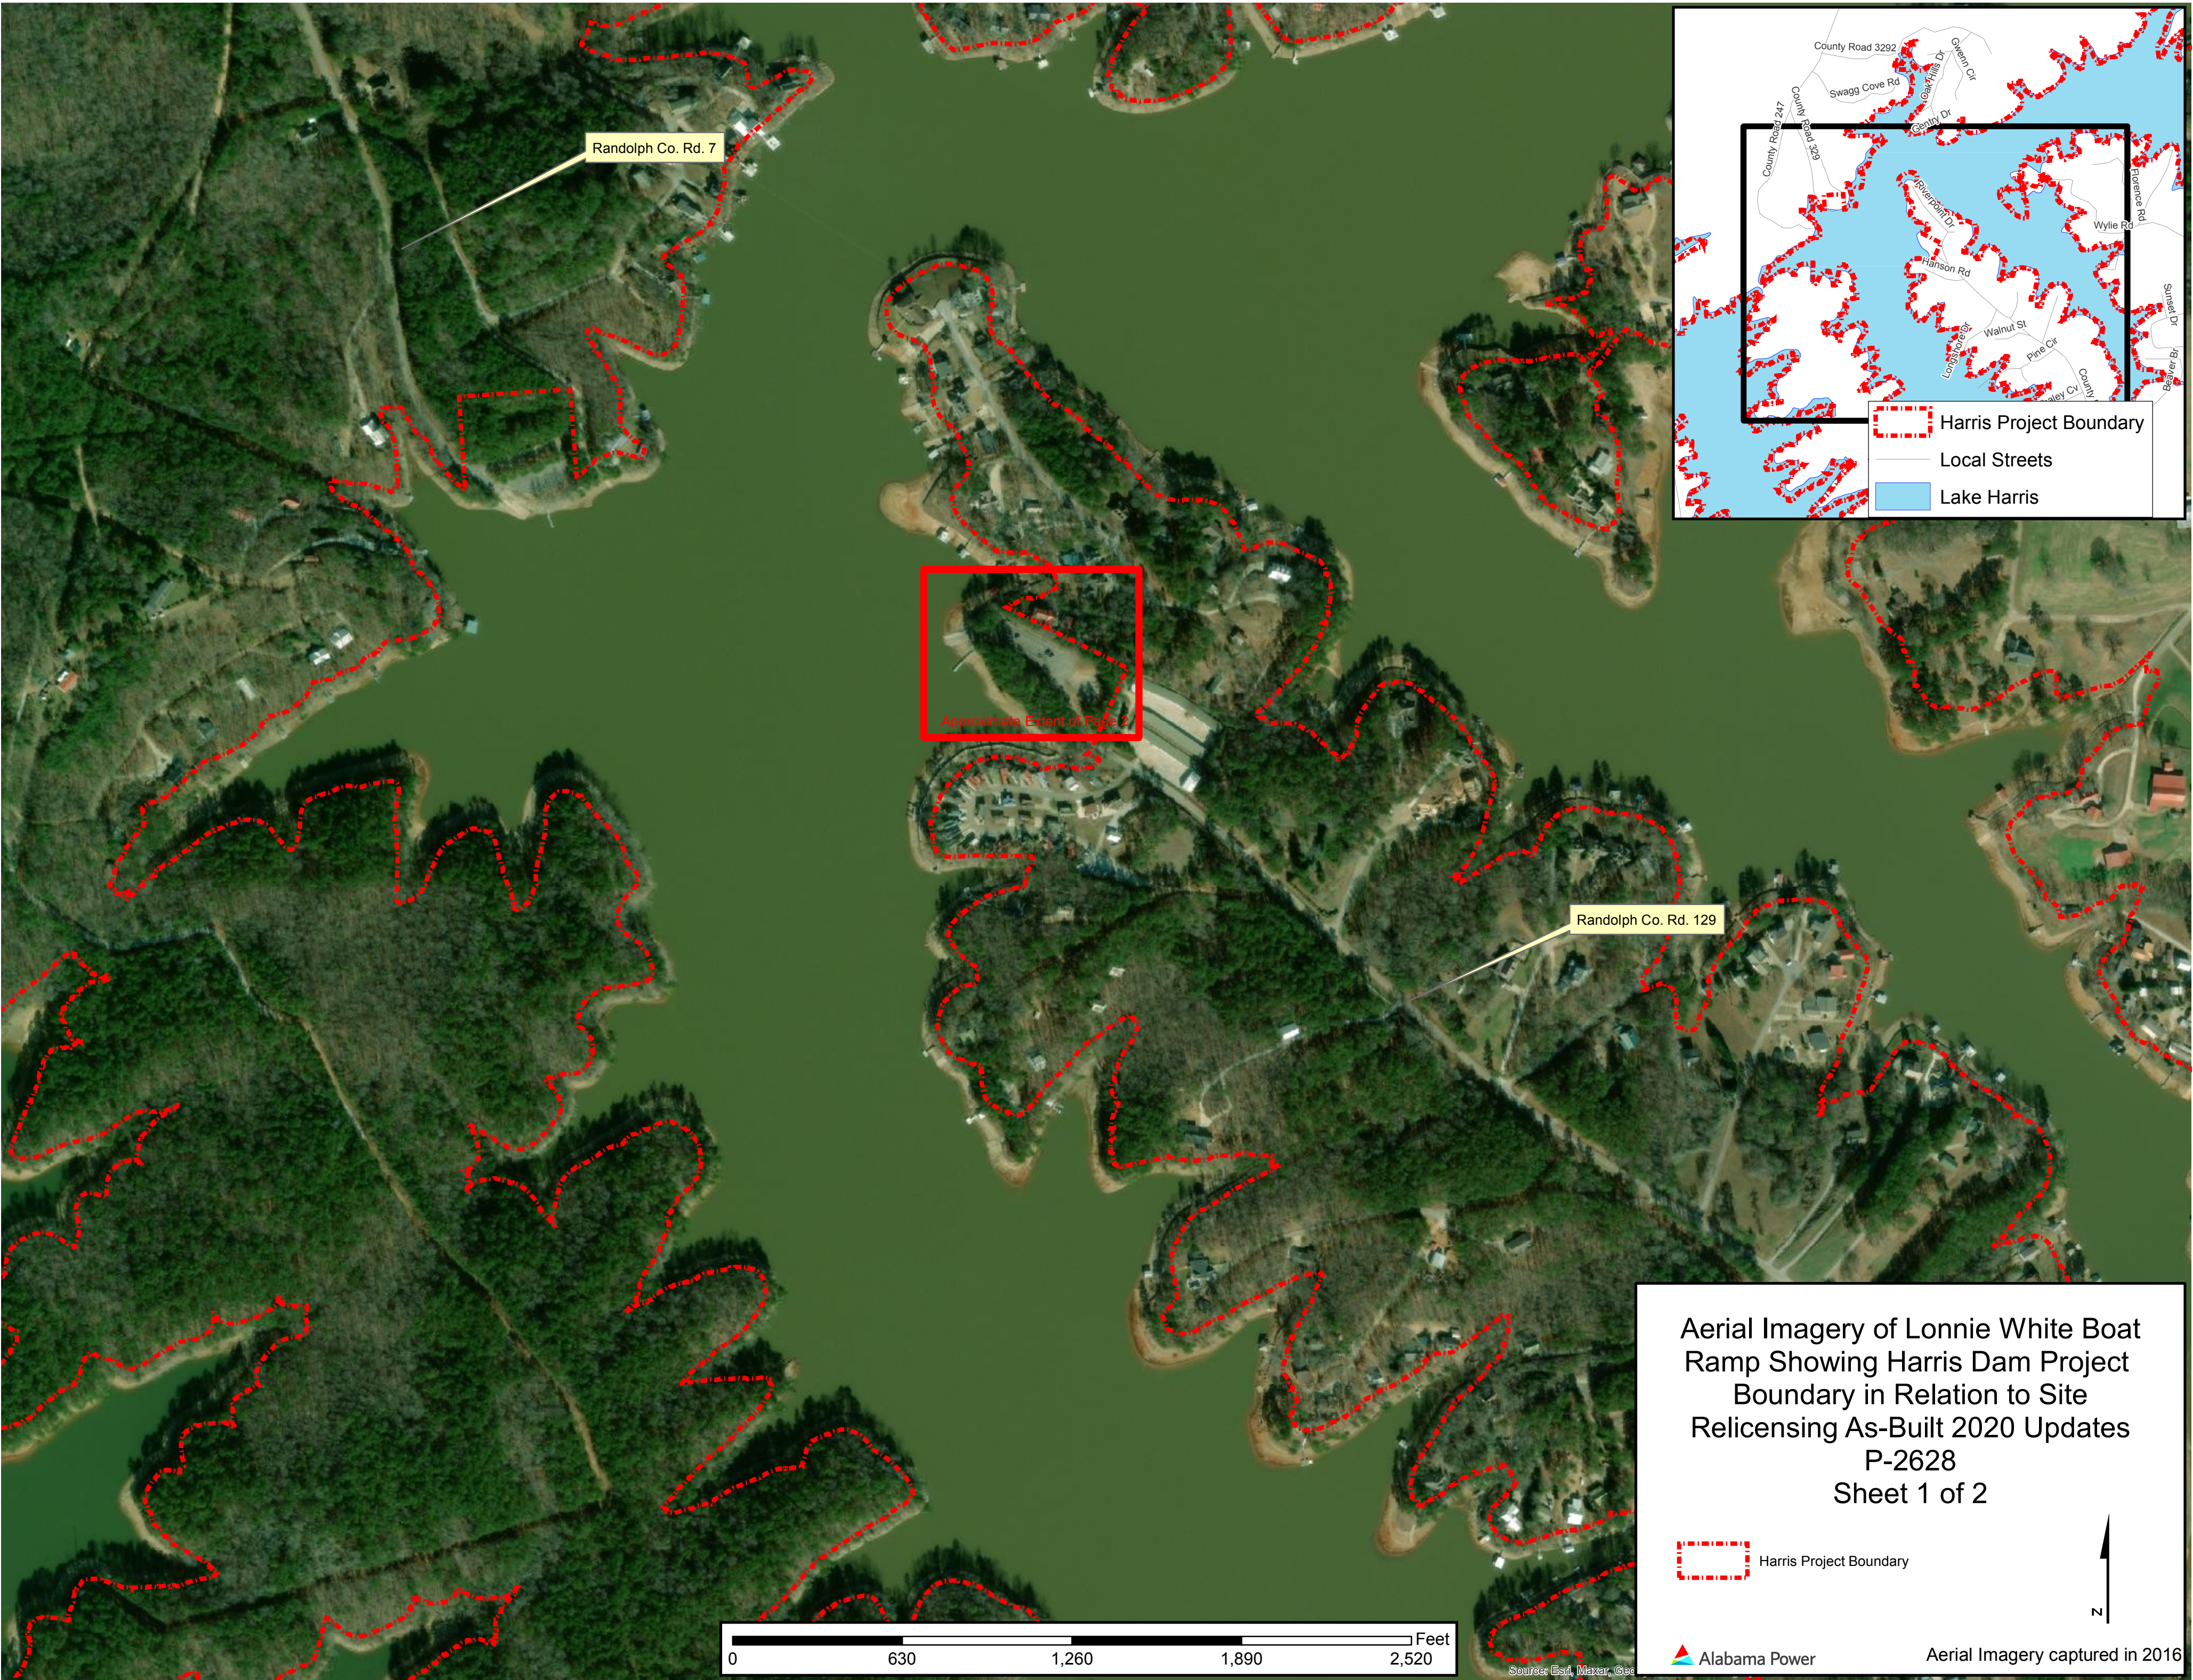



Aerial Imagery of Lonnie White  
Boat Ramp Relicensing  
As-Built 2020 Updates  
P-2628  
Sheet 2 of 2

Alabama Power Aerial Imagery captured in 2017



2 LANE BOAT LAUNCH

21 TRAILER PARKING SPACES

LAUNCHING PIER

~ 21 trailer parking spaces; 2 lane boat launch;  
Launching pier