
48th West Road

Approximate Extent of Page 2

AL HWY 48

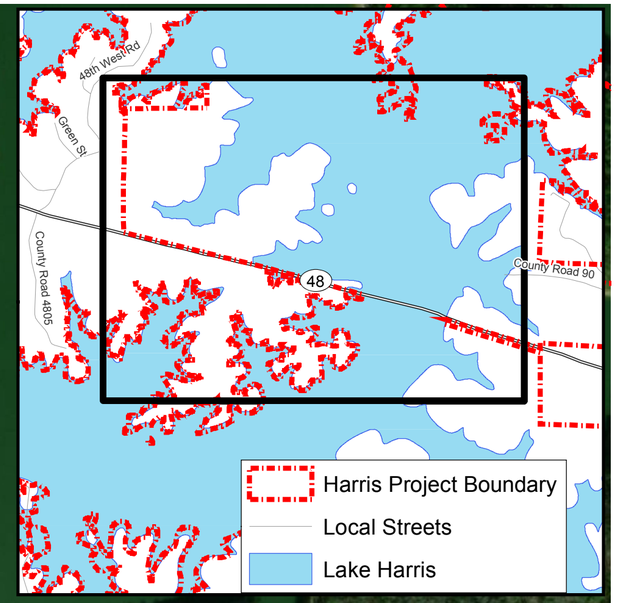

0 630 1,260 1,890 2,520 Feet

Source: Esri, Maxar, GeoE

Aerial Imagery of Hwy 48 Boat Ramp Showing Harris Dam Project Boundary in Relation to Site Relicensing As-Built 2020 Updates P-2628 Sheet 1 of 2

Harris Project Boundary

N

Alabama Power

Aerial Imagery captured in 2016

Aerial Imagery of Hwy 48 Boat Ramp Relicensing As-Built 2020
P-2628
Updates Sheet 2 of 2

N

Alabama Power Aerial Imagery captured in 2017

Barrier-free path from barrier-free trailer parking to Barrier-free launching pier

Barrier-free launching pier

Launching pier

2 lane boat launch



Barrier-free restroom

2 barrier-free trailer parking spaces

28 Trailer Parking Spaces


Barrier-free path

1 barrier-free trailer parking space

~ 27 trailer parking spaces and 3 barrier-free trailer parking spaces; 2 lane boat launch; Barrier-free launching pier and regular launching pier; Barrier-free path from barrier-free trailer space to barrier-free launching pier; Barrier-free restroom; Barrier-free path from barrier-free trailer space to barrier-free restroom

RANDOLPH CO. RD. 88

MAP EXTENT OF PAGE 2

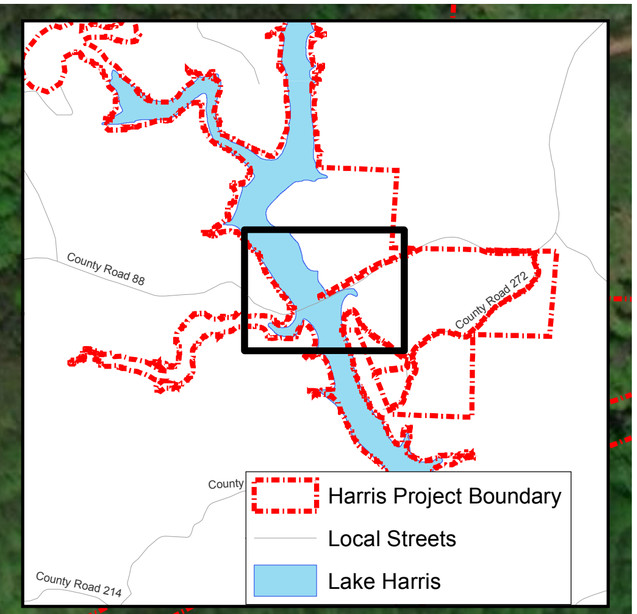

0 230 460 690 920 Feet

Aerial Imagery of Lee's Bridge Boat Ramp Showing Harris Dam Project Boundary in Relation to Site Relicensing As-Built 2020 Updates P-2628

Sheet 1 of 2

Harris Project Boundary

N

Alabama Power

Aerial Imagery captured in 2016

Source: Esri, Maxar, GeoEye, Earthstar Geographics, CNES/Airbus DS, USDA, USGS, AeroGRID, IGN, and the GIS User Community

Aerial Imagery of Lee's Bridge
Boat Ramp
Relicensing As-Built 2020
P-2628
Updates Sheet 2 of 2

N

Alabama Power Aerial Imagery captured in 2020

PATH FROM PARKING LOT TO LAUNCHING PIER

LAUNCHING PIER

4 TRAILER PARKING SPACES


1 LANE BOAT LAUNCH

~4 trailer parking spaces; 1 lane boat launch; 1 launching pier; Path from parking lot to launching pier

AL HWY 48

Randolph Co. Rd. 863

Approximate Extent of Page 2

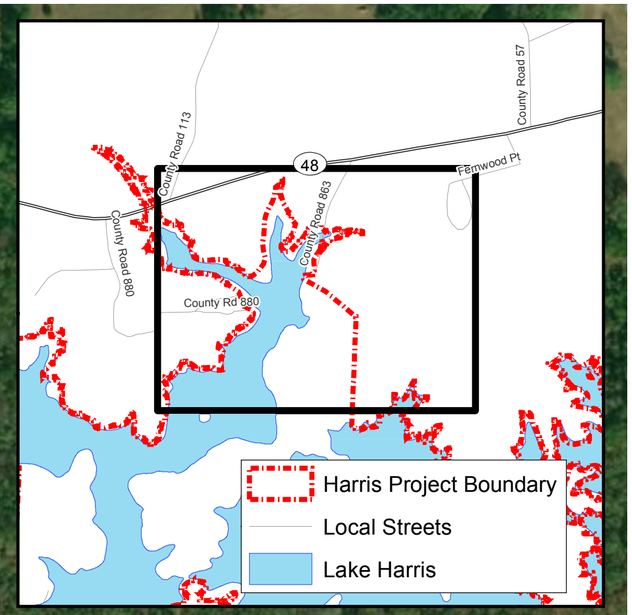

0 470 940 1,410 1,880 Feet

Aerial Imagery of Little Fox Creek Boat Ramp Showing Harris Dam Project Boundary in Relation to Site Relicensing As-Built 2020 Updates P-2628

Sheet 1 of 2

Harris Project Boundary

N

Alabama Power

Aerial Imagery captured in 2016

Source: Esri, Maxar, GeoEye, Earthstar Geographics, CNES/Airbus DS, USDA, USGS, AeroGRID, IGN, and the GIS User Community

Aerial Imagery of Little Fox Creek Boat Ramp Relicensing As-Built 2020 Updates

P-2628

Sheet 2 of 2

N

Alabama Power

Aerial Imagery captured in 2017



BARRIER-FREE PATH FROM BARRIER-FREE TRAILER PARKING TO BARRIER-FREE LAUNCHING PIER AND 2 LANE BOAT LAUNCH

20 TRAILER PARKING SPACES




2 BARRIER-FREE TRAILER PARKING SPACES

~ 20 trailer parking spaces and 2 barrier-free trailer parking spaces; Barrier-free launching pier; Barrier-free path from barrier-free trailer parking space to barrier-free launching pier and boat launch;
2 lane boat launch

Randolph Co. Rd. 7

Approximate Extent of Page 2

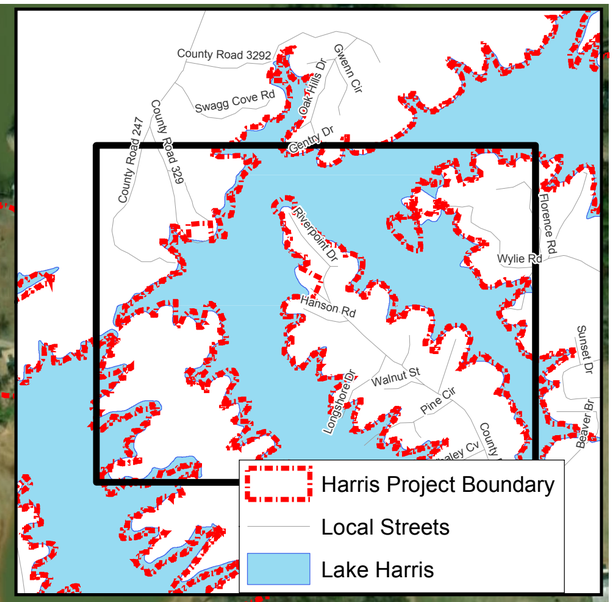

Randolph Co. Rd. 129

0 630 1,260 1,890 2,520 Feet

Source: Esri, Maxar, Geo

Aerial Imagery of Lonnie White Boat Ramp Showing Harris Dam Project Boundary in Relation to Site Relicensing As-Built 2020 Updates
P-2628
Sheet 1 of 2

Harris Project Boundary

N

Alabama Power

Aerial Imagery captured in 2016

Aerial Imagery of Lonnie White
Boat Ramp Relicensing
As-Built 2020 Updates
P-2628
Sheet 2 of 2

N

Alabama Power Aerial Imagery captured in 2017

21 TRAILER PARKING SPACES

2 LANE BOAT LAUNCH

LAUNCHING PIER

~ 21 trailer parking spaces; 2 lane boat launch; Launching pier